

**STATE OF UTAH**  
**DEPARTMENT OF NATURAL RESOURCES**  
**DIVISION OF OIL, GAS AND MINING**  
 1594 West North Temple - Suite 1210  
 Box 145801  
 Salt Lake City, Utah 84114-5801  
 Telephone: (801) 538-5291  
 Fax: (801) 359-3940

**LARGE MINING OPERATIONS PROGRESS REPORT**  
**January 1, 2012 to December 31, 2012**

The information required in this form is based on provisions of the Mined Land Reclamation Act, Title 40-8, and the R647 rules under the Utah Minerals Regulatory Program.

1. Mine Permit Number: M/029/0008
2. Mine Name: Morgan Quarry
3. Name of Operator/Permittee: Geneva Rock Products, Inc.

Note: If Operator's address, company representative or phone number have changed, please provide a replacement page for the Notice of Intention together with form MR-REV available on the Division's web page at [https://fs.ogm.utah.gov/pub/mines/minerals\\_related/forms/MR-REV.pdf](https://fs.ogm.utah.gov/pub/mines/minerals_related/forms/MR-REV.pdf).

4. Report the gross amount of ore mined and waste moved:

Gross Ore Mined 62,292 Tons, or \_\_\_\_\_ yd<sup>3</sup>  
 Waste Material Moved 0 Tons, or \_\_\_\_\_ yd<sup>3</sup>

5. Disturbance at the end of 2011 20 Acres  
 New Disturbance Created during 2012 2 Acres  
 Area Reclaimed and Fully Released during 2012 0 Acres  
 Total Disturbed Area at the end of 2012 22 Acres\*  
 Permitted/Bonded Acreage 38 Acres  
 \*The total disturbed area should not be greater than the permitted/bonded acreage


6. Briefly describe the reclamation work performed during the past year. (Submit form MR-SITE ([https://fs.ogm.utah.gov/pub/mines/minerals\\_related/forms/MR-SITE.pdf](https://fs.ogm.utah.gov/pub/mines/minerals_related/forms/MR-SITE.pdf)) to apply for full or partial bond/site release). Attach additional sheets if needed.  
No reclamation work has been performed during this period.

7. For large mines, include an updated map depicting surface disturbance and reclamation performed during the year (Rule R647-4-105).

**I hereby certify, under penalties of law, the information provided in this report is true and correct to the best of my knowledge and belief.**

Name (Typed or Print): Brent R. Sumsion  
 Title of Operator: Properties and Environmental Manager  
 Signature of Operator: [Signature]  
 Date: Jan 23, 2013



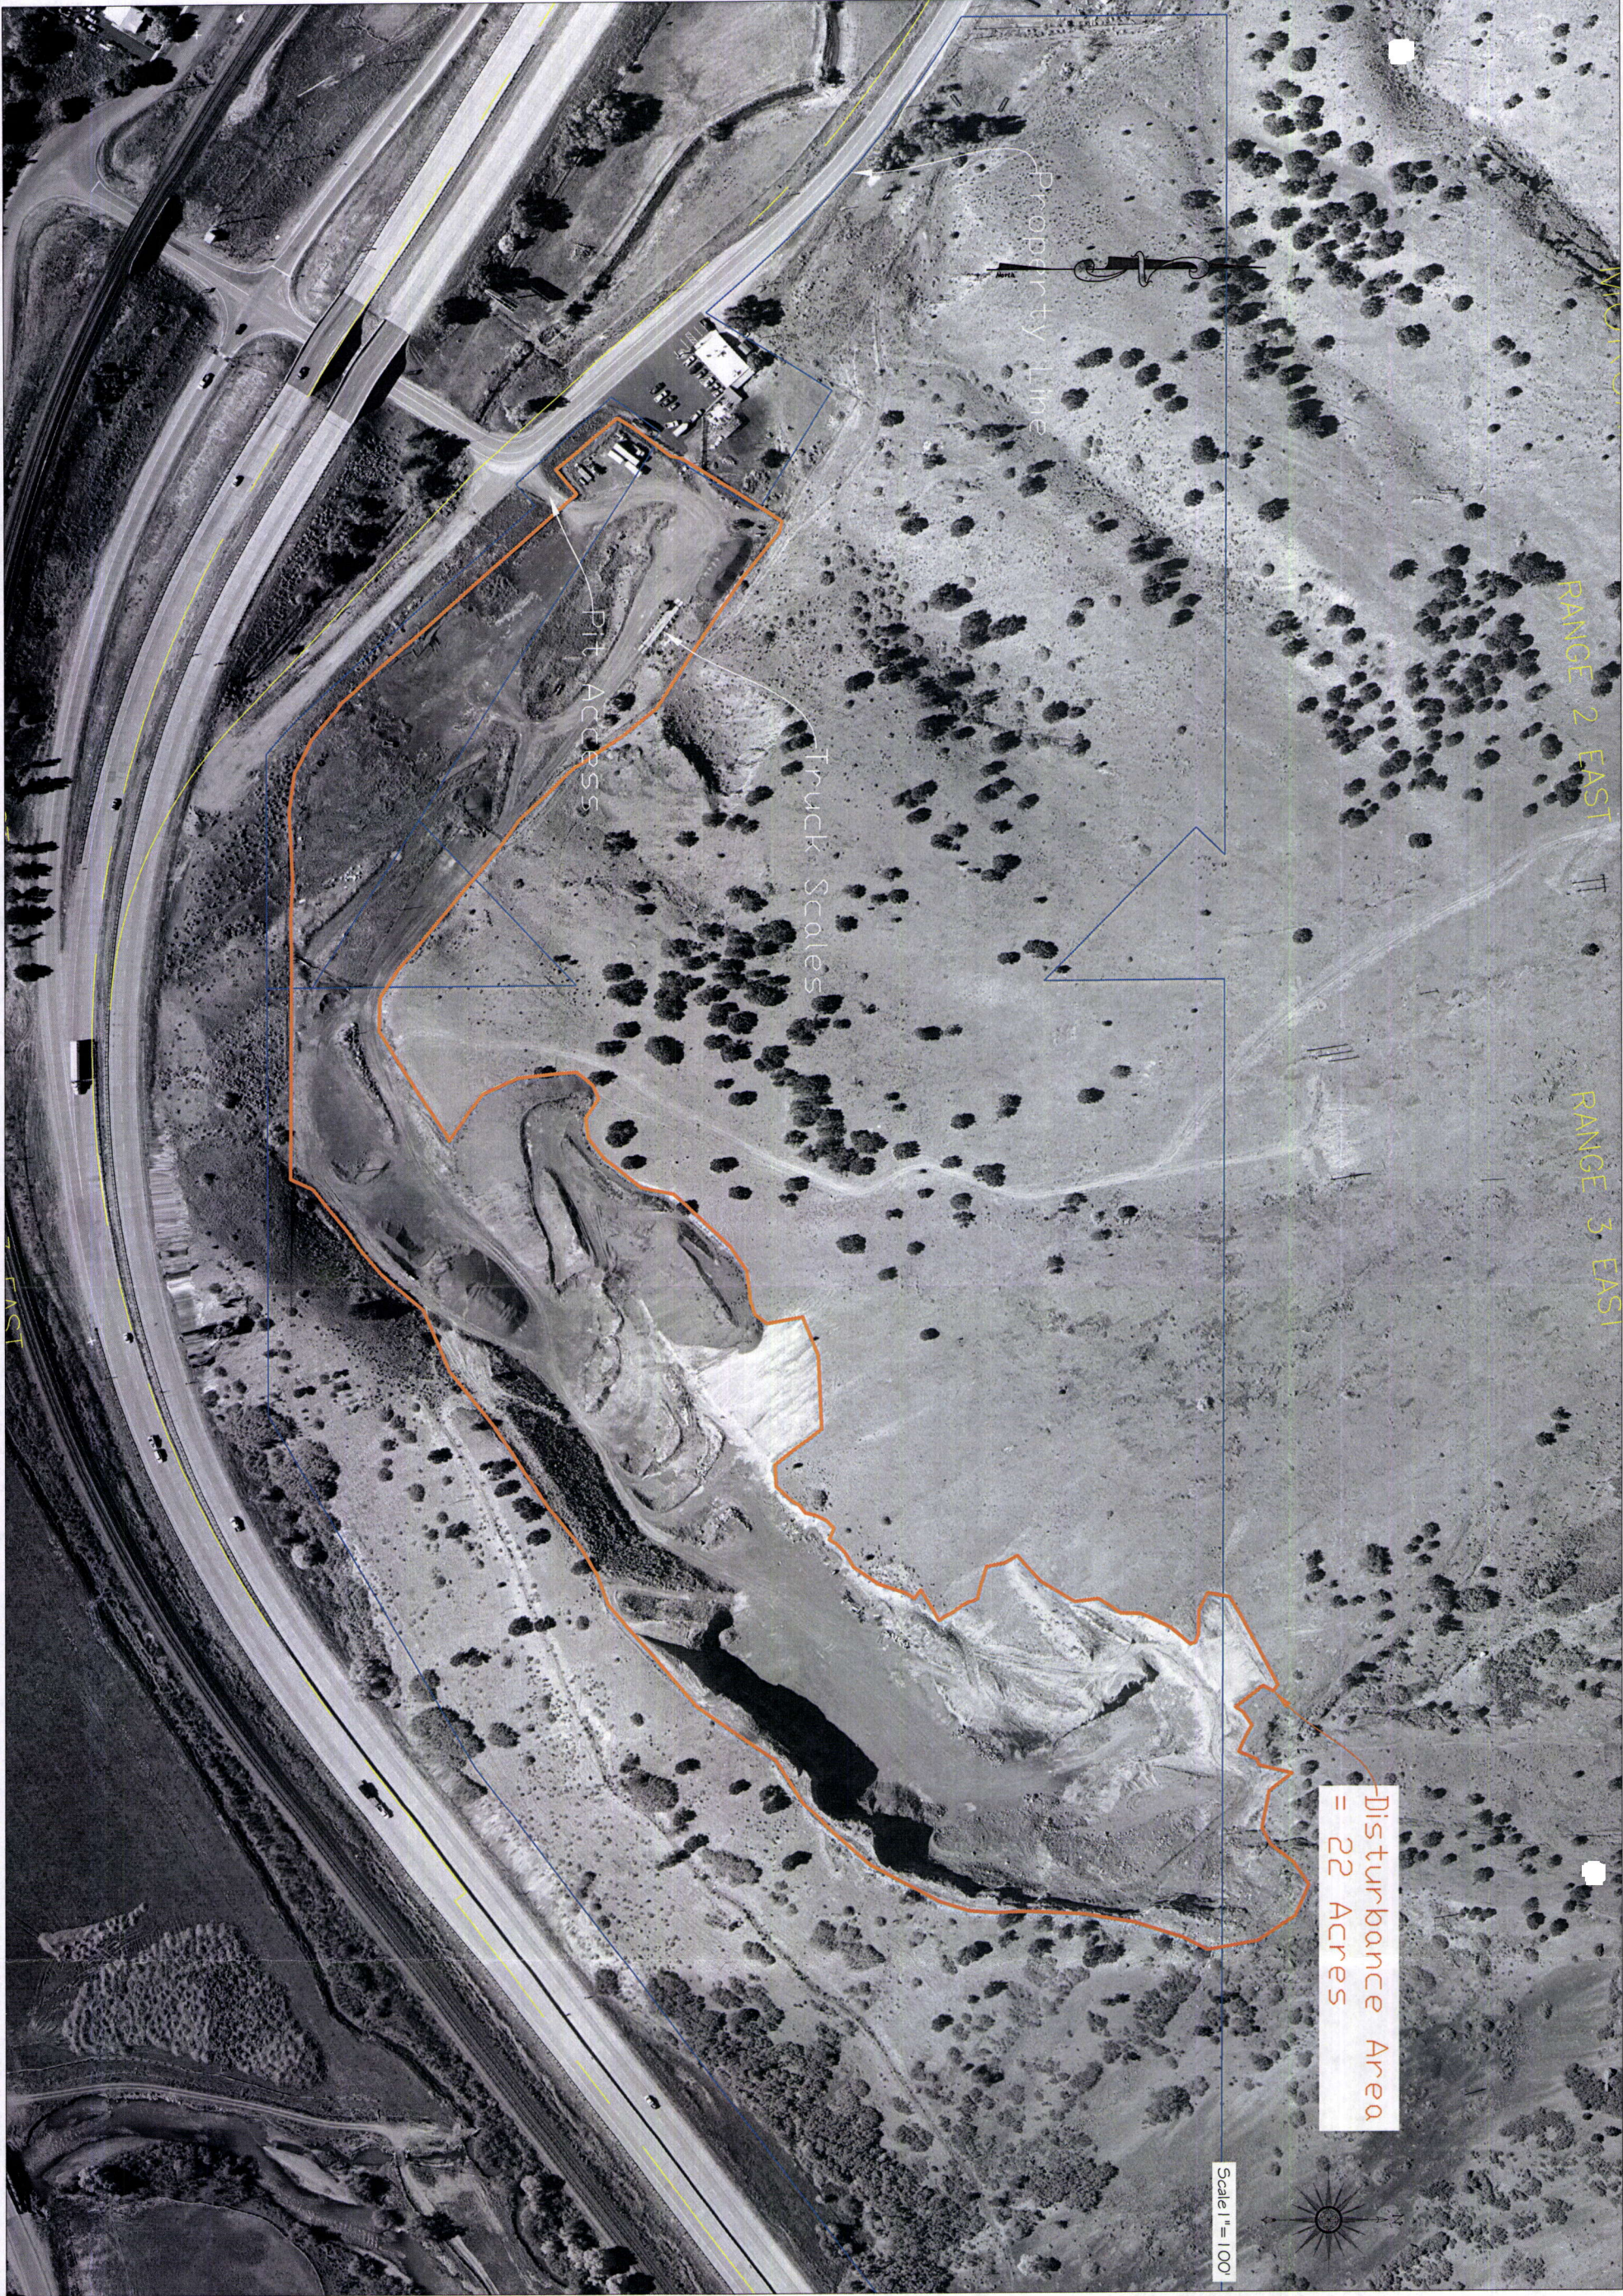

Project Info	
Surveyor:	R. KUNZ
Designer:	B. Summison
Begin Date:	11-01-11
Name:	GENEVA ROCK
Scale:	1"=100'
Checked:	
Number:	5603-09

Sheet	1
Sheets	1

MORGAN ORTHO PHOTO W/ BOUNDARY  
MORGAN COUNTY, UTAH  
GENEVA ROCK PRODUCTS, INC.  
MORGAN QUARRY

REVISIONS	
DATE	DESCRIPTION

Geneva Rock Products, Inc.  
730 N. 1500 W.  
Drem, Utah 84059  
801-802-6900